

ELEVATION SCHEDULE	DESIGN	AS-BUILT
TOP OF FOUNDATION	106.46	EXISTING
SEWER INVERT AT FOUNDATION	103.35	103.37
SEWER INVERT INTO SEPTIC TANK	103.14	103.22
SEWER INVERT OUT OF SEPTIC TANK	102.89	102.87
SEWER INVERT INTO D-BOX	102.57	102.64
SEWER INVERT OUT OF D-BOX	102.40	102.47
SEWER INVERT INTO LEACHING SYSTEM	102.28	102.32
TOP OF CHAMBER (BREAKOUT)	102.78	102.82
IMPERVIOUS BARRIER	102.85	102.96
BOTTOM OF LEACHING FIELD	101.70	101.74
WATER TABLE (TP-1)	97.61	97.61

THE SOLE INTENT OF THIS PLAN IS TO ACCURATELY DEPICT THE LOCATION OF THE SEPTIC SYSTEM COMPONENTS AND TO ATTEST AS TO THEIR CONFORMANCE / NON CONFORMANCE TO THE DIMENSIONAL REGULATIONS SET FORTH BY 310 CMR 15.00 (TITLE 5) AND THE LOCAL BOARD OF HEALTH ON THE DATE SHOWN ON SAID PLAN. NO CERTIFICATION IS EXPRESSED OR IMPLIED AS TO THE PERFORMANCE OF THE SYSTEM SHOWN HEREON.

1.) THE INTENT OF THIS PLAN IS TO SHOW AS-BUILT CONDITIONS FOR A CERTIFICATE OF COMPLIANCE.

2.) LOCUS PROPERTY IS COMPRISED OF: ASSESSOR'S MAP 11 PLOT 13

4.) BENCHMARK A: NAIL IN UTILITY POLE #6 ELEV=100.00' (DATUM: ASSUMED) BENCHMARK B: NAIL IN UTILITY POLE #7 ELEV=107.57' (DATUM: ASSUMED)

5.) THE PROPERTY LINE INFORMATION SHOWN IS BASED ON CURRENT AVAILABLE RECORD INFORMATION CONSISTING OF PLANS AND DEEDS AND AN ACTUAL ON THE GROUND FIELD SURVEY PERFORMED BY THIS FIRM ON 02-05-2020.


6.) COMMUNITY PANEL NUMBER: 25027C1031E (DATE: 07-04-2011) THE FLOOD INSURANCE RATE MAP DEFINES THIS AREA AS ZONE X, AREA OUTSIDE THE 0.2% CHANCE ANNUAL FLOOD

7.) THE LOCATION OF EXISTING UNDERGROUND INFRASTRUCTURE, UTILITIES, CONDUITS AND LINES ARE SHOWN IN AN APPROXIMATE WAY ONLY, MAY NOT BE LIMITED TO THOSE SHOWN HEREON, AND HAVE BEEN RESEARCHED BASED ON THE AVAILABLE UTILITY RECORDS AT THE

DATE

WITH THE ORDER OF CONDITIONS SET FORTH IN DEP FILE #218-0794. 7/6/2020

THE SOLE INTENT OF THIS SANITARY DISPOSAL AS—BUILT IS TO ACCURATELY DEPICT THE LOCATION OF THE SEPTIC SYSTEM COMPONENTS AND TO ATTEST AS TO THEIR CONFORMANCE / NON CONFORMANCE TO THE DIMENSIONAL REGULATIONS SET FORTH BY 310 CMR 15.00 (TITLE 5) AND THE LOCAL BOARD OF HEALTH ON THE DATE SHOWN ON SAID PLAN. NO CERTIFICATION IS EXPRESSED OR IMPLIED AS TO THE PERFORMANCE OF THE SYSTEM SHOWN HEREON.

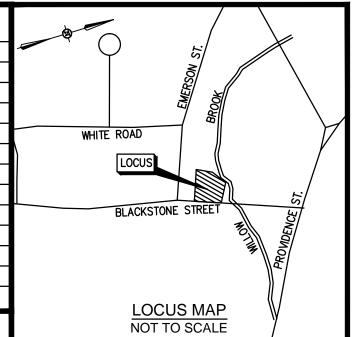

PERMITTING SET

REVISIONS

No.	DATE	DESCRIPTION
DRAWN BY:		MPJ/ALL/JVW
CHECKED BY:		: GWD/EPJ
DESIGNED BY:		Y: GWD


SANITARY DISPOSAL SYSTEM AS-BUILT PLAN

13 BLACKSTONE STREET IN **MENDON** (WORCESTER COUNTY) **MASSACHUSETTS**

JULY 6, 2020


PREPARED FOR:

SIMAR HOUSE, INC 102 MAPLE SPRINGS RD WAREHAM, MA 02571

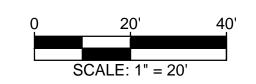



200 North Bedford Street East Bridgewater, Massachusetts 02333 Phone: 508-378-3421 www.pmpassoc.com

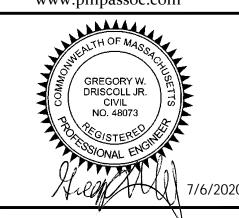

SHEET

JOB NUMBER: 02-2019-047